



South Elevation

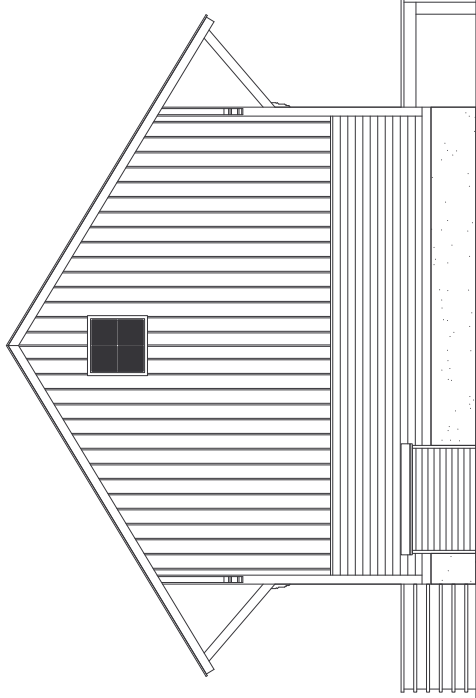

North Elevation

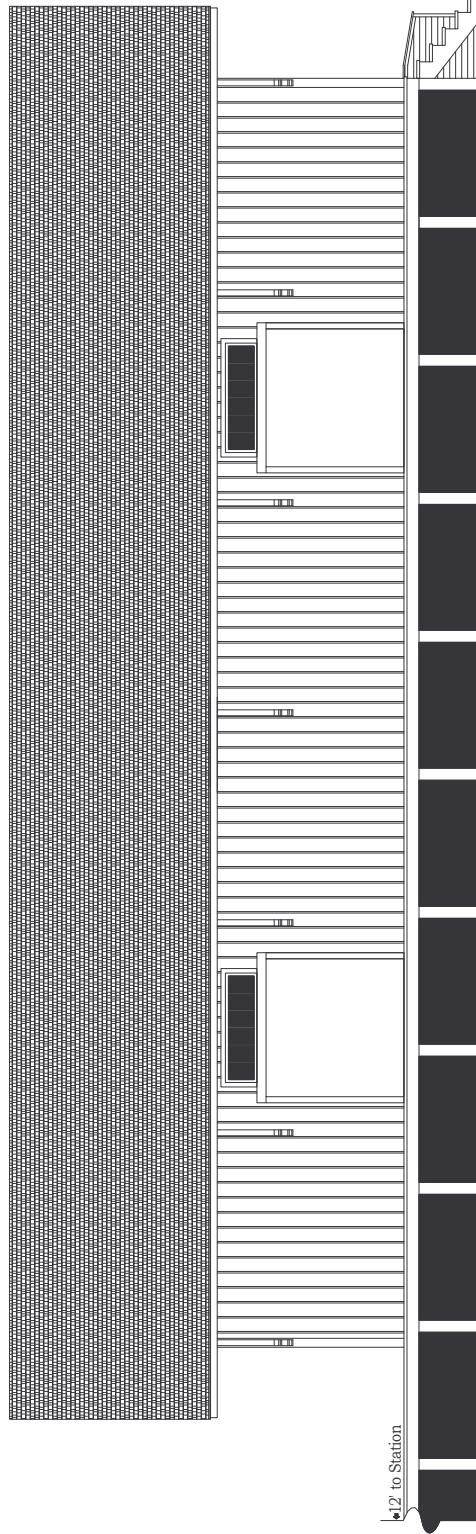

East Elevation



Scale: 3/32" = 1'

DELAWARE & HUDSON RAILROAD
North Creek Freight House

Based on field measurements & photos / JRP 12/2008
As built in 1903, north end shows siding added to all sides in 1928.