
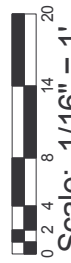


East Elevation

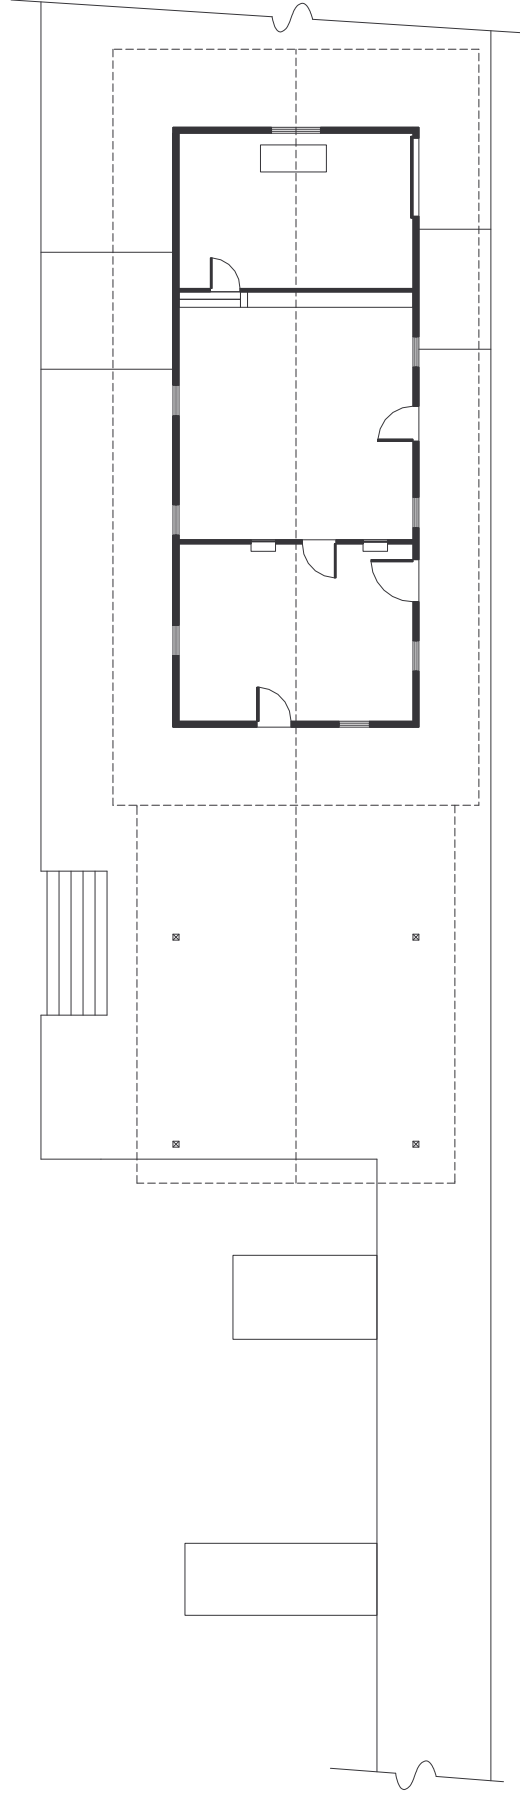

Based on field measurements and photos - drawn 9/2/02
as built in 1872 with porch added

DELAWARE & HUDSON RAILROAD
North Creek Station