



West Elevation

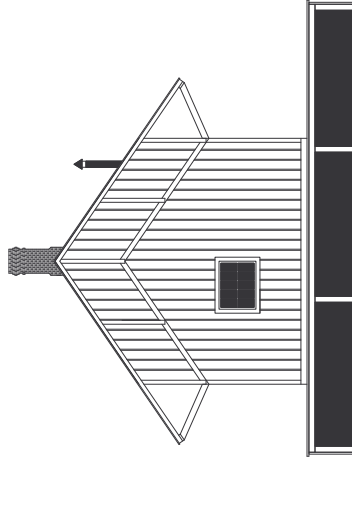

North Elevation

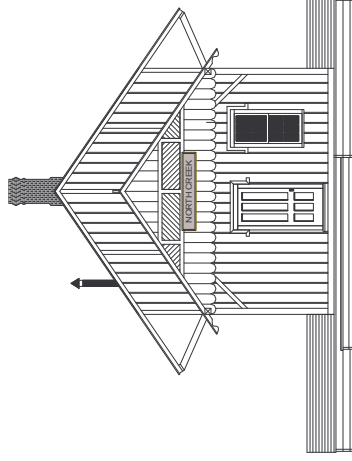

South Elevation



Scale: 1/16" = 1'

DELAWARE & HUDSON RAILROAD
North Creek Station

Based on field measurements and photos - drawn 9/14/02
as built in 1872 with porch added