


East Elevation

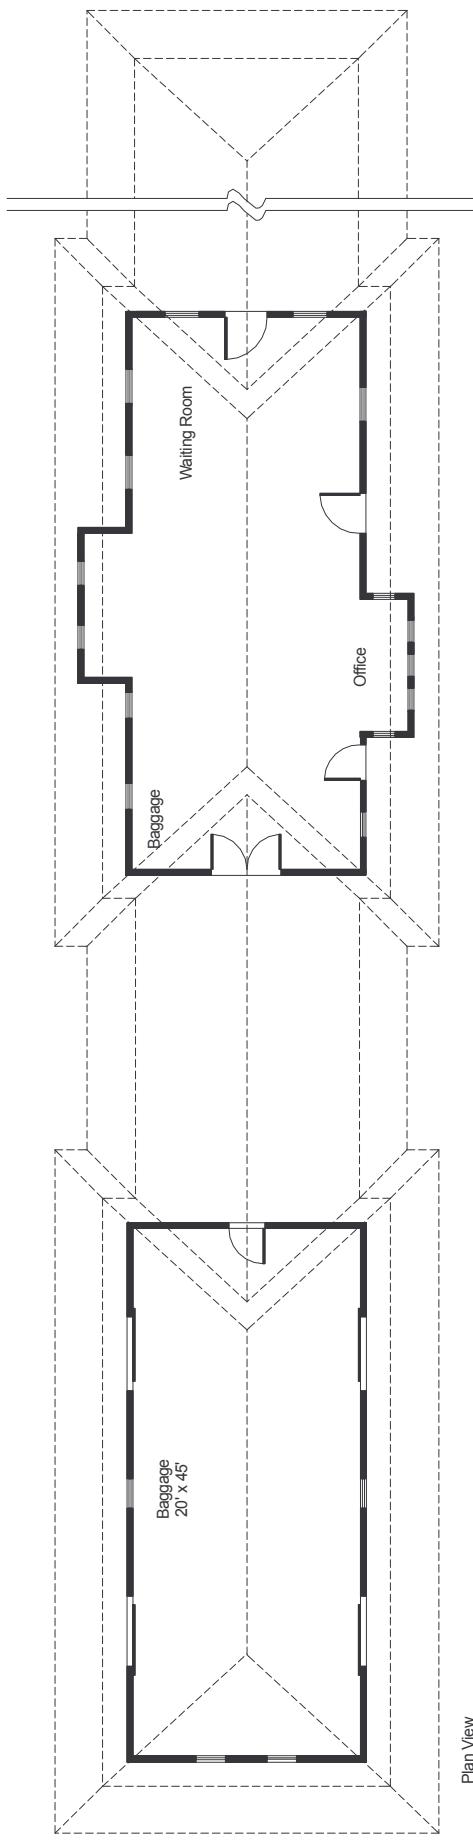

Plan View

Scale: 1/16" = 1'
0 2 4 8 14 20

DELAWARE & HUDSON RAILROAD
Riverside Station

Based on field measurements - drawn 8/17/02
as built in 1913 with 1922 baggage room